


SCHAEFER CENTER FOR THE PERFORMING ARTS - RIGGING SCHEDULE

EXISTING LINE #	DESCRIPTION	RIGGING EQUIPMENT	DISTANCE FROM PLASTER LINE	BATTEN	BATTEN LENGTH	ARBOR CAPACITY	SUSPENSION ASSEMBLY	CURTAIN FABRIC	FABRIC COLOR	LINING FABRIC	FULLNESS	CURTAIN TRACK	CURTAIN SIZE
1	LINE 1 - VALANCE	EXISTING	1'-0"	EXISTING	63'-0"	UNCHANGED	EXISTING	25oz VELOUR	COGNAC	"RANGER"	50%		60'-0" W x 6'-0" H
2	LINE 2 - MAIN CURTAIN	EXISTING	2'-0"	EXISTING	63'-0"	UNCHANGED	EXISTING	25oz VELOUR	COGNAC	"RANGER"	50%	EXISTING	32'-0" W x 26'-0" H x 2 PANELS
3	LINE 3 - TEASER	EXISTING	3'-2"	EXISTING	63'-0"	UNCHANGED	EXISTING						
4	LINE 4 - LEGS	EXISTING	3'-10"	EXISTING	63'-0"	UNCHANGED	EXISTING						
5	LINE 5 - ELECTRIC	EXISTING	4'-6"	EXISTING	63'-0"	UNCHANGED	EXISTING						
6	LINE 6 - GENERAL PURPOSE	EXISTING	5'-2"	EXISTING	63'-0"	UNCHANGED	EXISTING						
7	LINE 7 - GENERAL PURPOSE	EXISTING	5'-10"	EXISTING	63'-0"	UNCHANGED	EXISTING						
8	LINE 8 - PROJECTION SCREEN	EXISTING	6'-6"	EXISTING	63'-0"	UNCHANGED	EXISTING						
9	LINE 9 - SHELL CEILING 1	NEW	7'-4"*	TRUSS	63'-0"	3500#	BRACKET						
10	LINE 10 - GENERAL PURPOSE	EXISTING	8'-8"	EXISTING	63'-0"	UNCHANGED	EXISTING						
11	LINE 11 - GENERAL PURPOSE	EXISTING	9'-4"	EXISTING	63'-0"	UNCHANGED	EXISTING						
12	LINE 12 - GENERAL PURPOSE	EXISTING	10'-0"	EXISTING	63'-0"	UNCHANGED	EXISTING						
13	LINE 13 - GENERAL PURPOSE	EXISTING	10'-8"	EXISTING	63'-0"	UNCHANGED	EXISTING						
14	LINE 14 - BORDER	EXISTING	11'-4"	EXISTING	63'-0"	UNCHANGED	EXISTING						
15	LINE 15 - LEGS	EXISTING	12'-0"	EXISTING	63'-0"	UNCHANGED	EXISTING						
16	LINE 16 - GENERAL PURPOSE	EXISTING	12'-8"	EXISTING	63'-0"	UNCHANGED	EXISTING						
17	LINE 17 - ELECTRIC	EXISTING	13'-4"	EXISTING	63'-0"	UNCHANGED	EXISTING						
18	LINE 18 - GENERAL	EXISTING	14'-0"	EXISTING	63'-0"	UNCHANGED	EXISTING						
19	LINE 19 - BLACKOUT TRAVELER	EXISTING	14'-8"	EXISTING	63'-0"	UNCHANGED	EXISTING						
20	LINE 20 - PROJECTION SCREEN	EXISTING	15'-4"	EXISTING	63'-0"	UNCHANGED	EXISTING						
21	LINE 21 - GENERAL PURPOSE	EXISTING	16'-0"	EXISTING	63'-0"	UNCHANGED	EXISTING						
22	LINE 22 - GENERAL PURPOSE	EXISTING	16'-8"	EXISTING	63'-0"	UNCHANGED	EXISTING						
23	LINE 23 - BORDER	EXISTING	17'-4"	EXISTING	63'-0"	UNCHANGED	EXISTING						
24	LINE 24 - LEGS	EXISTING	18'-0"	EXISTING	63'-0"	UNCHANGED	EXISTING						
25	LINE 25 - SHELL CEILING 2	NEW	19'-4"	TRUSS	63'-0"	3500#	BRACKET						
26	REMOVED												
27	LINE 26 - ELECTRIC	EXISTING	20'-8"	EXISTING	63'-0"	UNCHANGED	EXISTING						
28	LINE 27 - GENERAL PURPOSE	EXISTING	21'-2"*	EXISTING	63'-0"	UNCHANGED	EXISTING						
29	LINE 28 - GENERAL PURPOSE	EXISTING	22'-0"	EXISTING	63'-0"	UNCHANGED	EXISTING						
30	LINE 29 - TRAVELER	EXISTING	22'-8"	EXISTING	63'-0"	UNCHANGED	EXISTING						
31	LINE 30 - GENERAL PURPOSE	EXISTING	23'-4"	EXISTING	63'-0"	UNCHANGED	EXISTING						
32	LINE 31 - GENERAL PURPOSE	EXISTING	24'-0"	EXISTING	63'-0"	UNCHANGED	EXISTING						
33	LINE 32 - GENERAL PURPOSE	EXISTING	26'-0"	EXISTING	63'-0"	UNCHANGED	EXISTING						
34	LINE 33 - BORDER	EXISTING	26'-8"	EXISTING	63'-0"	UNCHANGED	EXISTING						
35	LINE 34 - LEGS	EXISTING	27'-4"	EXISTING	63'-0"	UNCHANGED	EXISTING						
36	LINE 35 - GENERAL PURPOSE	EXISTING	28'-0"	EXISTING	63'-0"	UNCHANGED	EXISTING						
37	LINE 36 - ELECTRIC	EXISTING	28'-8"	EXISTING	63'-0"	UNCHANGED	EXISTING						
38	LINE 37 - GENERAL PURPOSE	EXISTING	29'-4"	EXISTING	63'-0"	UNCHANGED	EXISTING						
39	LINE 38 - GENERAL PURPOSE	EXISTING	30'-0"	EXISTING	63'-0"	UNCHANGED	EXISTING						
40	LINE 39 - SHELL CEILING 3	NEW	31'-4"*	TRUSS	63'-0"	3500#	BRACKET						
41	LINE 40 - GENERAL PURPOSE	EXISTING	32'-4"*	EXISTING	63'-0"	UNCHANGED	EXISTING						
42	LINE 41 - BORDER	EXISTING	32'-10"	EXISTING	63'-0"	UNCHANGED	EXISTING						
43	LINE 42 - GENERAL PURPOSE	EXISTING	33'-6"	EXISTING	63'-0"	UNCHANGED	EXISTING						
44	LINE 43 - SCRIM	EXISTING	34'-0"	EXISTING	63'-0"	UNCHANGED	EXISTING						
45	LINE 44 - CYCLORAMA	EXISTING	34'-10"	EXISTING	63'-0"	UNCHANGED	EXISTING						
46	LINE 45 - UPSTAGE TRAVELER	EXISTING	35'-6"	EXISTING	63'-0"	UNCHANGED	EXISTING						
47	LINE 46 - MUSLIN BOUNCE	EXISTING	36'-2"	EXISTING	63'-0"	UNCHANGED	EXISTING						

NOTES: -VALANCE, MAIN CURTAIN, AND TRUSS BATTENS INSTALLED BY PRODUCTIONS UNLIMITED. ALL OTHER CURTAINS, TRACKS, ELECTRIC RACEWAYS AND ORCHESTRA SHELL CEILINGS INSTALLED BY OTHERS.
 -TRUSS BATTENS FOR ORCHESTRA SHELL CEILINGS FABRICATED BY PRODUCTIONS UNLIMITED, INC.
 -POWERASSIST HOISTS AND ARBORS FOR ORCHESTRA SHELL LINE SETS PROVIDED BY J.R. CLANCY, INC.
 -EXISTING LOFT BLOCKS ARE RATED FOR A 725 # W.L.L. AND ARE TO BE RE-USED.
 -NEW CURTAINS FABRICATED BY STAGE DECORATIONS & SUPPLIES, INC.

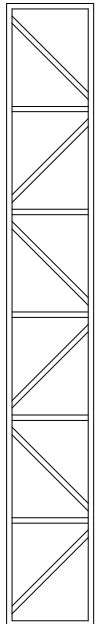

PRODUCTIONS UNLIMITED, INC.
 870 ANDERSON RIDGE ROAD
 GREER, SOUTH CAROLINA 29651
 864-675-6146
 FAX 864-675-0820

JOB: APPALACHIAN STATE UNIVERSITY - SCHAEFER CENTER FOR THE PERFORMING ARTS	
LOCATION: Boone, North Carolina	CONTRACT WITH: Rodgers Builders, Inc.
PROJECT MANAGER: Jonathan Mercer	FILE NAME: Stage Rigging Plan Rev A.dwg
TITLE: Stage Rigging Plan	
DATE: 7/22/13	
BY: JKH-M	
REVISION: AB	
DRAWING: STAGE RIGGING SCHEDULE	
SHEET NO: ASU-SR-01	